(517) (81205) 66-2934

January 20, 2011 2:55 PM

AIRP SEC NO	QTY PER AIRP	USED ON DWG NO.	MODEL	AIRPLANE SERIAL NUMBERS	PART NUMBER	RELEASE COLUMN INDICATOR	DRAWING SHEET NO.
56		5-46536	KC-135		66-2934		

REV LTR	REVISION (BRIEF DESCRIPTION OF CHANGE WITH REASON FOR CHANGE CHANGE EFFECTIVE INFORMATION (PRODUCTION AND TOOLING INFORMATION BEFORE ORAS ETC	ORIG/VAR REQUESTED	APPROVED	DEL DATE
A	ADDED F-2.20 FINISH TO WASHER REASON: CORRECTION OF DRAFTING ERROR PROD INFO: REWORK EXISTING PARTS CHANGE EFFECTIVE: 55-3136 & ON ZABG 16-65-10, 1-31-67	VAR 6-72-5-4 PRR 9500 E.L. OATHEL R. Moore		
B	REVISE T/B CHG EFF: REMOVED 60-369 & ON	VAR PRR 9500 E. ZAHNOW		

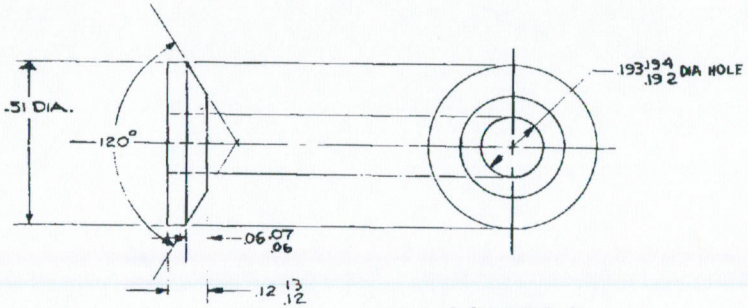

66-2934
(FOUR TIMES SIZE)

66-2934
(FULL SIZE)

B ISSUE

66-2934

LATEST ATTACHMENTS
ARDM'S

ODA'S

REQD	PART NUMBER	NOMENCLATURE	STOCK SIZE (APPROX NET)	MATERIAL	HEAT TREAT	FINISH	REV LTR
–	66-2934	WASHER	.25x.75DIA	[1]	–	F-2.20	A

[1] MAKE FROM BAR OR ROD
2024-T4
QQ-A-268 ALUMINUM ALLOY
T4 TEMPER
TAG PART NO PER BAC 5307

~~FORM, PUNCH, STRAIGHTEN, AND FIT METAL PARTS PER BAC 5300~~

MATERIAL SUBSTITUTIONS AND EQUIVALENTS PER BAC 5005

~~BOLT AND NUT INSTALLATIONS PER BAC 5007~~

SEE BACD2077 FOR SURFACE ROUGHNESS.
ALL DIMENSIONS IN INCHES.
HEAT TREAT SPECIFICATIONS:
STEEL: MIL-H-6875, BAC5601
AL. ALLOY: MIL-H-6088, BAC5602
RIVET PER BAC 5004.
BEND RADIUS TOLERANCE: - .01 ON .031 & .064; - .03 ON .094 & GREATER
SHT METAL CORNER RADIUS
1 MIN. INTERNAL
.22 EXTERNAL (OPTIONAL) EXCEPT AS NOTED. FOR FINISH CODE SEE DWG 2-5060.

SCALE FULL SIZE & NOTED
TOLERANCES E: .25PT AS NOTED: LINEAR ±.0 ANGULAR ±1/4

DRAWN	C.E. DULLER	
CHECKED	R. Moore	2/7/57
STRESS CK		
GROUP APPR		
PROJ APPR		

WASHER, DOOR ACTUATOR

BOEING AIRPLANE COMPANY
SEATTLE 14, WASHINGTON

66-2934

PRR 3368

DRAWING ORIGINATED BY (GROUP): HYDRAULICS
2-8-57

CODE 81205

DRAWING RECORDS CLERK